



Rhif y Cais / Application Number : C17/0198/30/LL



Cynllun lleoliad ar gyfer adnabod y safle yn unig. Dim i raddfa.
Location Plan for identification purposes only. Not to scale.

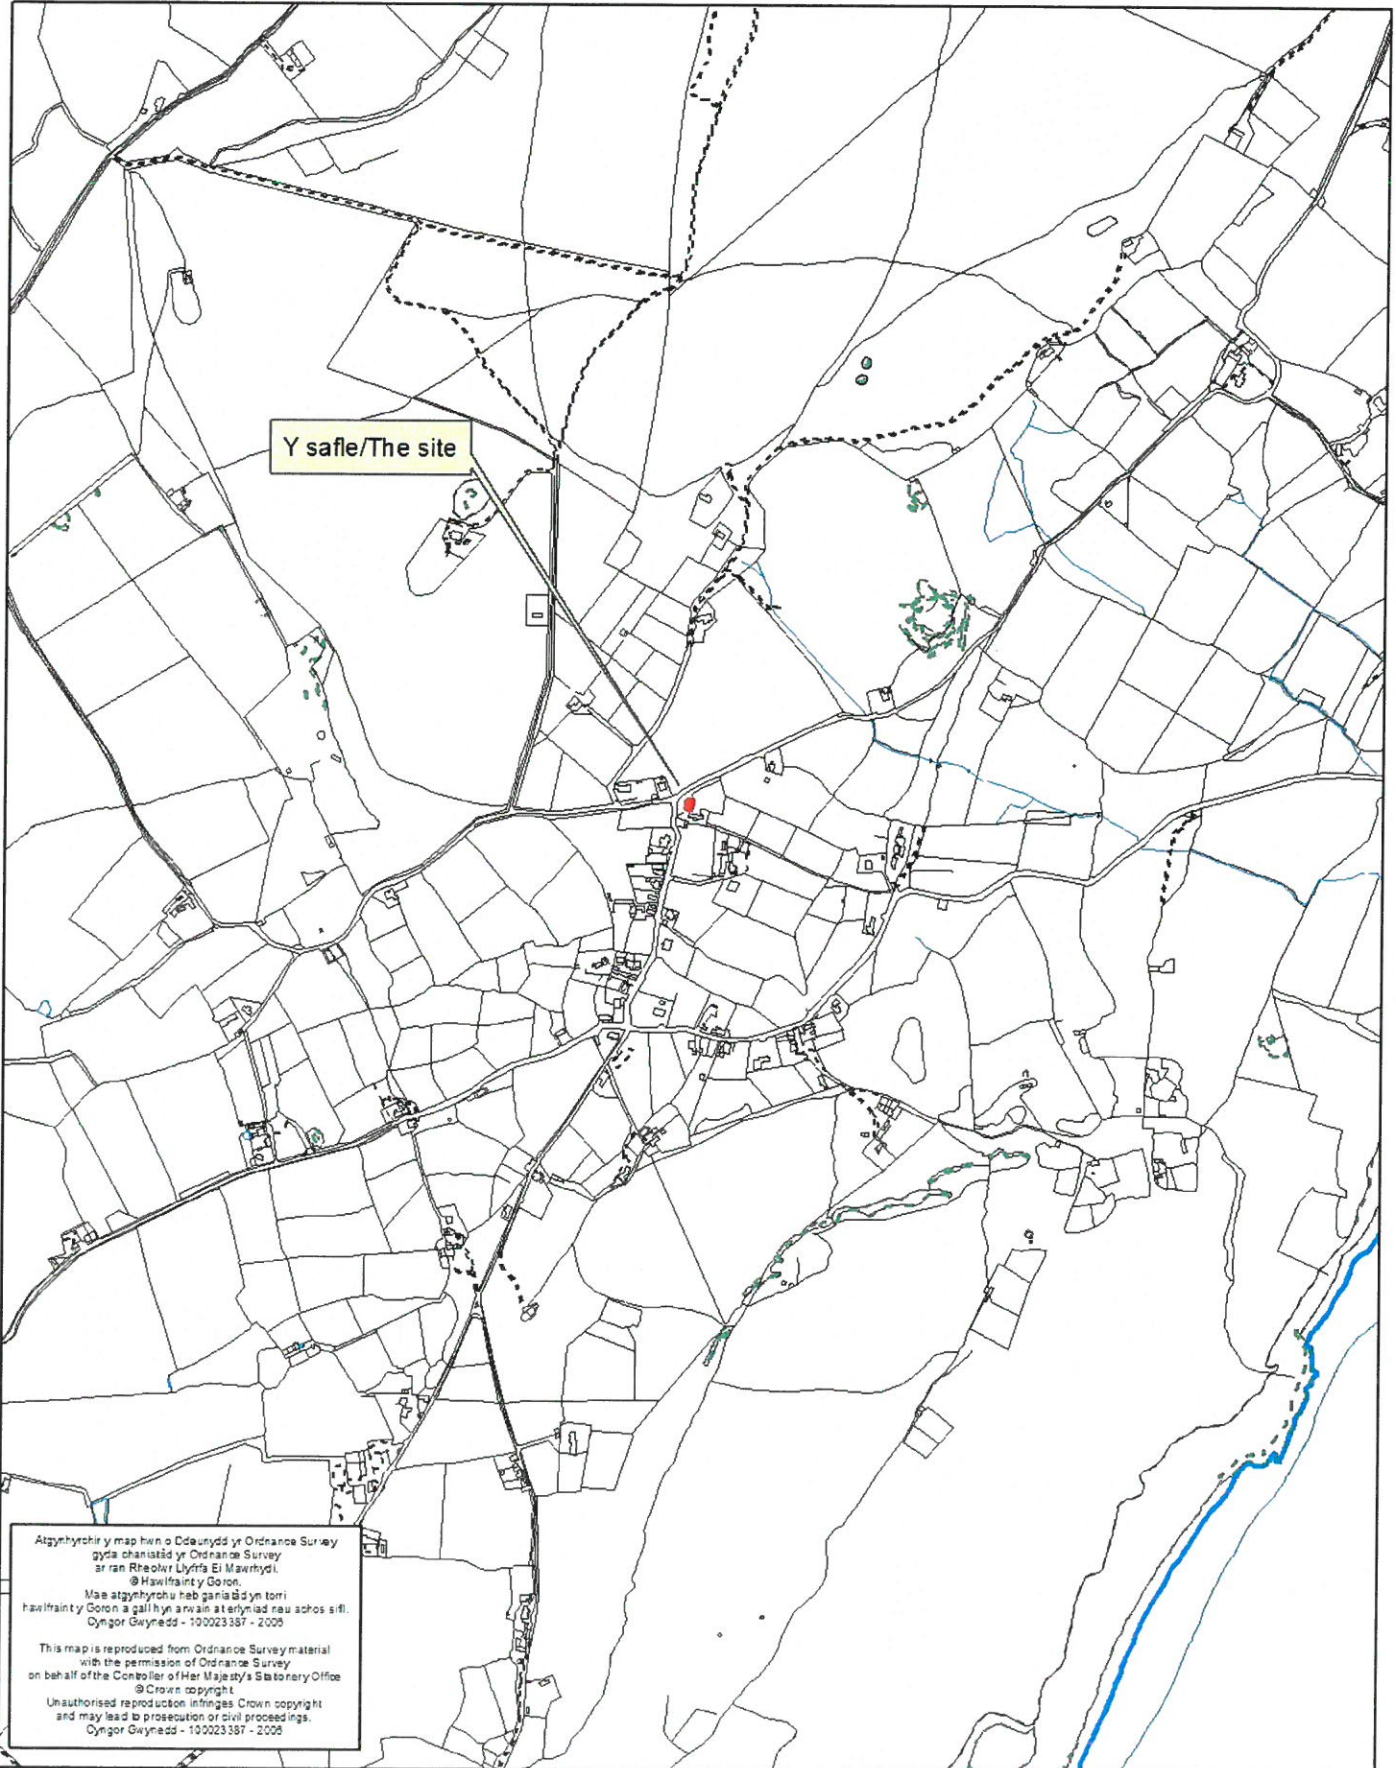

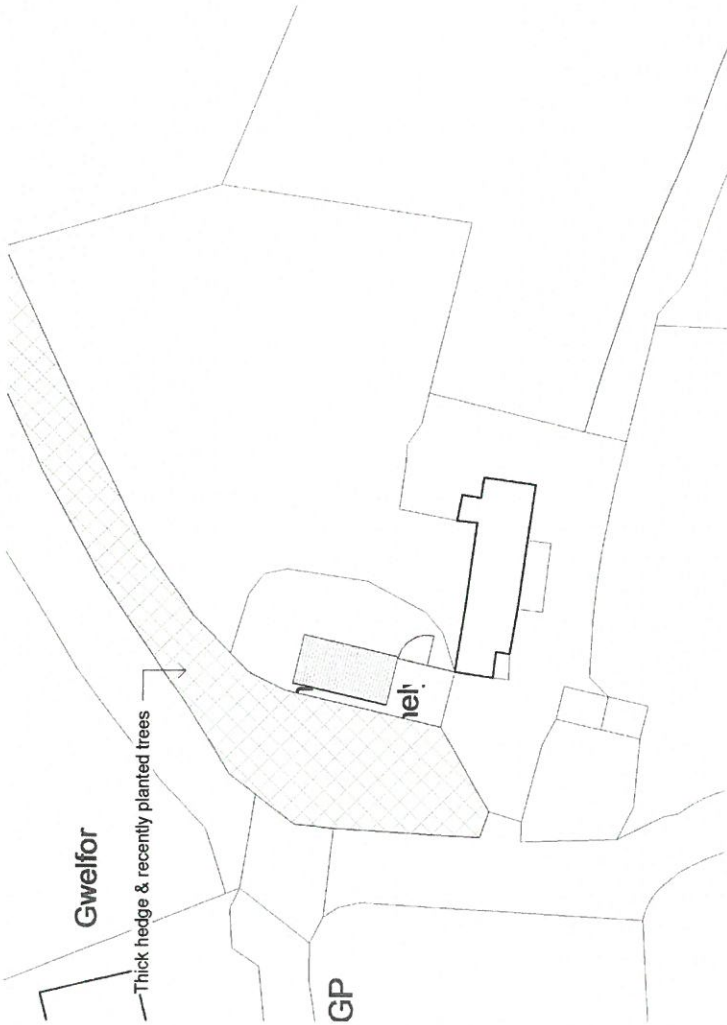

1 Site - Proposed

1 : 500

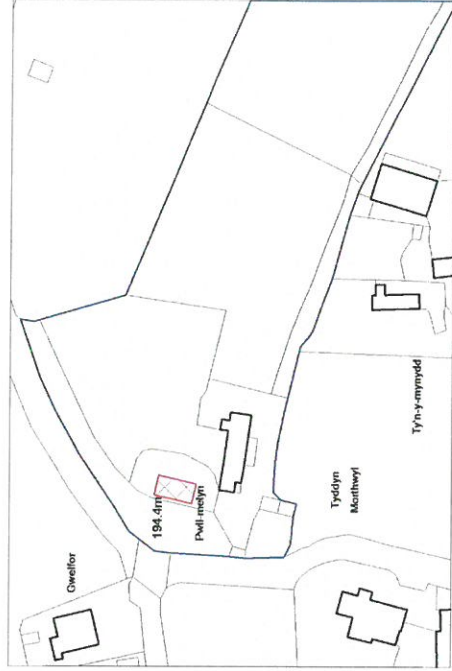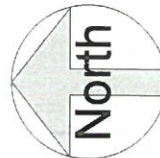

2 Location

1 : 1250

No.	Description	Date



**Haydn E.
Williams Cyf.**
Syrfewyr Adeiladu Siartredig
Chartered Building Surveyors




Gellidara, Penrhos, Pwllheli, Gwynedd, LL63 7HF
(01758) 614444
info@haydnwilliams.com
www.haydnwilliams.com

TEITL PROSIECT - PROJECT TITLE
Pwll Melyn, Rhiw


TEITL - TITLE
Site Location Plan

CLIENT - CLIENT		Elizabeth Thornton	
DYDDIAD - DATE	RHIF PROSIECT - PROJECT NUMBER	GRADDFA - SCALE @ AS	As Indicated
02/02/17	0453		
DARLWYDD GAN DWARBY	GEW	RHIF CYNLLUN - DRAWING NUMBER	REV
GWRWYD GAN CHECKED BY	HEW	0453-L101	


Do not scale this drawing. Contractors must check all dimensions from site. This drawing is copyright.

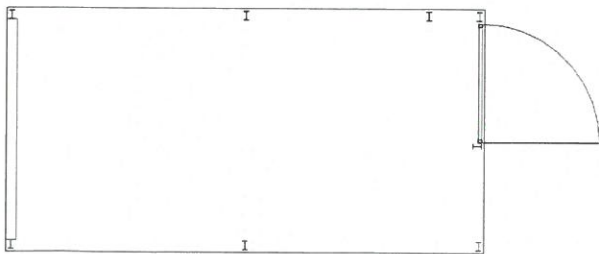


1
Level 0
1 : 100

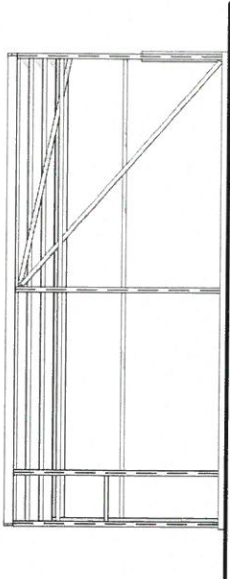


2
East
1 : 100

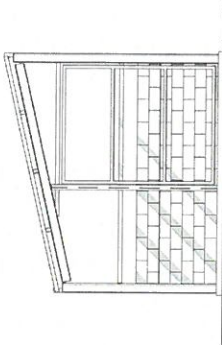


3
South
1 : 100

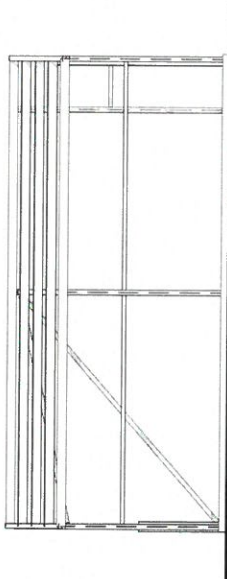

4
West
1 : 100

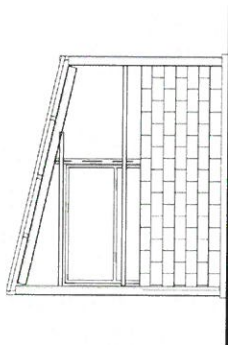

5
North
1 : 100

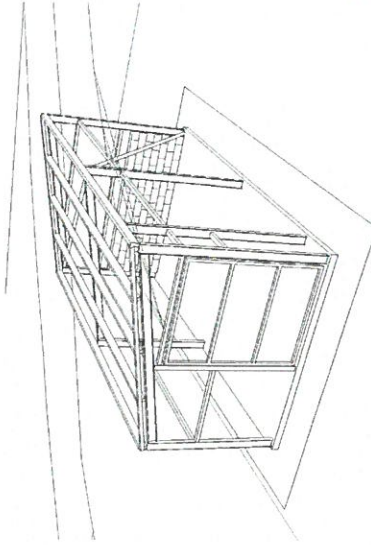

6
3D View 1

No.	Description	Date

Do not scale this drawing. Contractors must check all dimensions from site. This drawing is copyright.

Haydn E. Williams Cyf.
Syrffwyr Adeiladu Siartredig
Chartered Building Surveyors

RICS
Gellidara, Penrhos, Pwllheli, Gwynedd, LL53 7HF
(01758) 814444
info@haydnwilliams.com
www.haydnwilliams.com

TEITL PROSIECT - PROJECT TITLE
Pwll Melyn, Rhiw

TEITL - TITLE
As Existing


CLEIENT - CLIENT
Elizabeth Thornton

BYDDAD - DATE 02/02/17	RHIF PROSIECT - PROJECT NUMBER 0453	GRADDFA - SCALE @ A3 1 : 100
DARLWYDD GAN DORWEN F. HEW	RHIF CYLLUN - DRAWING NUMBER 0453-A101	REV
GWRWYD GAN C-CHECKED BY	GEW	

Outline of existing roof slope shown in red.
Proposed reduction in roof height by changing to a duo pitched roof.

CYNLLUN DIWYCHIEDIG
REVISED PLAN


Derbynwyd/Received: **31/3/17**
Llofnod/signature: *H. E. Williams*

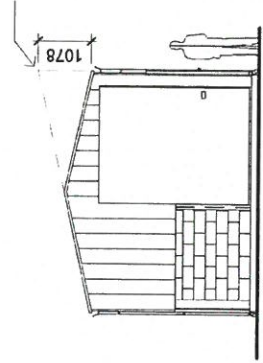

3 South - Proposed


1 : 100

Dark green profiled side cladding and roofing sheets.

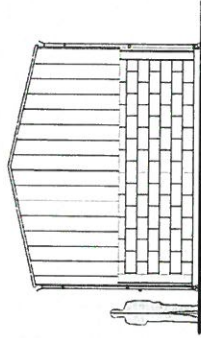


5 North - Proposed

1 : 100

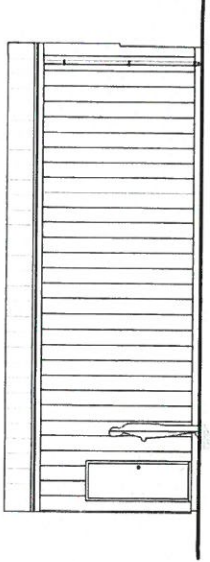


2 East - Proposed

1 : 100

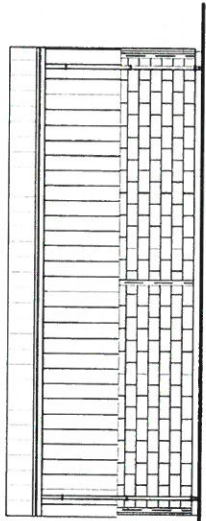

4 West - Proposed


1 : 100

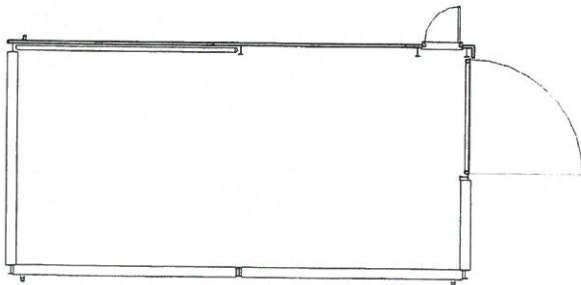

1 Level 0 - Proposed

1 : 100

CYNGOR GWYNEDD
ADRAN RHIFODDION
31 MAW 2017
GWASANAETH CYNLLUNIO AC
AMGYLCHEDD
RHIFTRAC

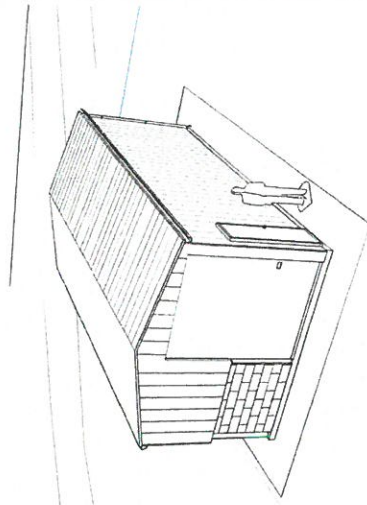

3D View 1 Copy 1

6

<p>Do not scale this drawing. Contractors must check all dimensions from site. This drawing is copyright.</p>		<p>Haydn E. Williams Cyf. Syrfewyr Adeiladu Siartredig Chartered Building Surveyors Gellidara, Penrhos, Pwllheli, Gwynedd, LUS3 7HF (01759) 614444 info@haydnwilliams.com www.haydnwilliams.com</p>		<p>TEITL PROSIECT - PROJECT TITLE Pwll Melyn, Rhiw</p>		<p>CLEIENT - CLIENT Elizabeth Thornton</p>					
<p>No. A</p>		<p>Description Reduce roof height</p>		<p>Date 30/3/17</p>		<p>DYDDIAD - DATE 02/02/17</p>		<p>RHIF PROSIECT - PROJECT NUMBER 0453</p>		<p>GRADDFA - SCALE (@ A3) 1 : 100</p>	
						<p>DARLWYDD GAN DRAWN BY HEW</p>		<p>RHIF CYNLLUN - DRAWING NUMBER 0453-A102</p>		<p>REV A</p>	
						<p>GWRWDD GAN CHECKED BY GEW</p>					